(10)

(11)

T.O. HIGH PARAPET EL = 32'-0' T.O. LOW PARAPET EL = 30'-0'

T.O. ROOF STRUCTURE

EL = 29'-0'


HEAD OF WINDOWS

EL = 22'-0'

SECOND FLOOR EL = 14'-0'

TOP OF CONCRETE SL

T.O. CANOPY EL = 9'-0'

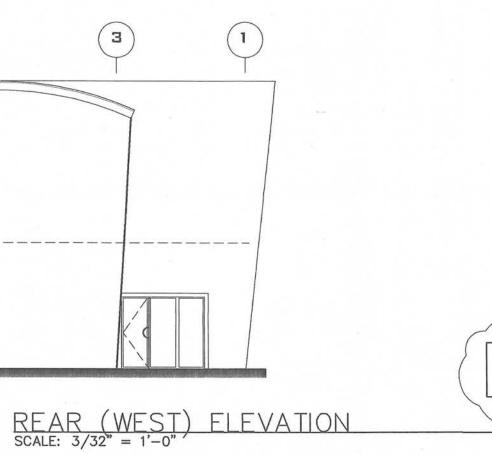

* VARIANCE REQUIRED (T.O. ROOF STRUCTURE = 29'-0")
** AS PER ARTICLE III HEIGHT OF BUILDING, SEC. 33-55 EXEMPTIONS.

ANGEL MILANES, AIA AR-0015845

A - 3.0

architects planners 12901 S.W. 132 AVENUE MIAMI, FLORIDA 33186

T. (305) 278-7776 F. (305) 278-7473 WWW.BELLONMILANES.COM

AA-0003505

ARCHITECTURE LAND PLANNING

INTERIORS

CONSTRUCTION MANAGEMENT

DRAWN: A.V./C.B.

CHECKED: AM. PROJ. NO: 2005BM489

1. 05-07-2007 (HEARING) 2.\ 11-06-2007 (HEARING)

BDC: BUILDING DEPT. COMMENTS CC: COORDINATION CHANGES AB: AS-BUILT RAP: REVISION AFTER APPROVAL

ZONING HEARINGS SECTION
WILAMI-DADE PLANNING AND ZONING DEPT.
BY______ LEOPOLDO BELLON, AIA AR-008757